

Rev	AS CONSTRUCTED PLANS	App'd	B.1	JUN 2015	Date
A	AS CONSTRUCTED PLANS	App'd	B.1	JUN 2015	Date

File name 300271SAC.dwg, layout name 300447\_SAC 1  
 File location G:\30\300271\ACAD  
 plotted by Brendan Dobb, plot date 27/7/2015 5:32 PM  
 © Spire Australia Pty Ltd  
 Standard Drawing SEWMA - Version 20130204


Scale 1:400 A1  
 Horizontal 0 1 2 3 4 5 6 7 8 9 10 20

**Map Reference** VR 608 K10  
**Sheet Number** 01  
**Severage Authority** Offer  
 SHE15800

**Map Reference** VR 608 K10  
**Sheet Number** 01  
**Severage Authority** Offer  
 SHE15800

**Map Reference** VR 608 K10  
**Sheet Number** 01  
**Severage Authority** Offer  
 SHE15800

Map Reference VR 608 K10  
 Sheet Number 01  
 Severage Authority Offer  
 SHE15800

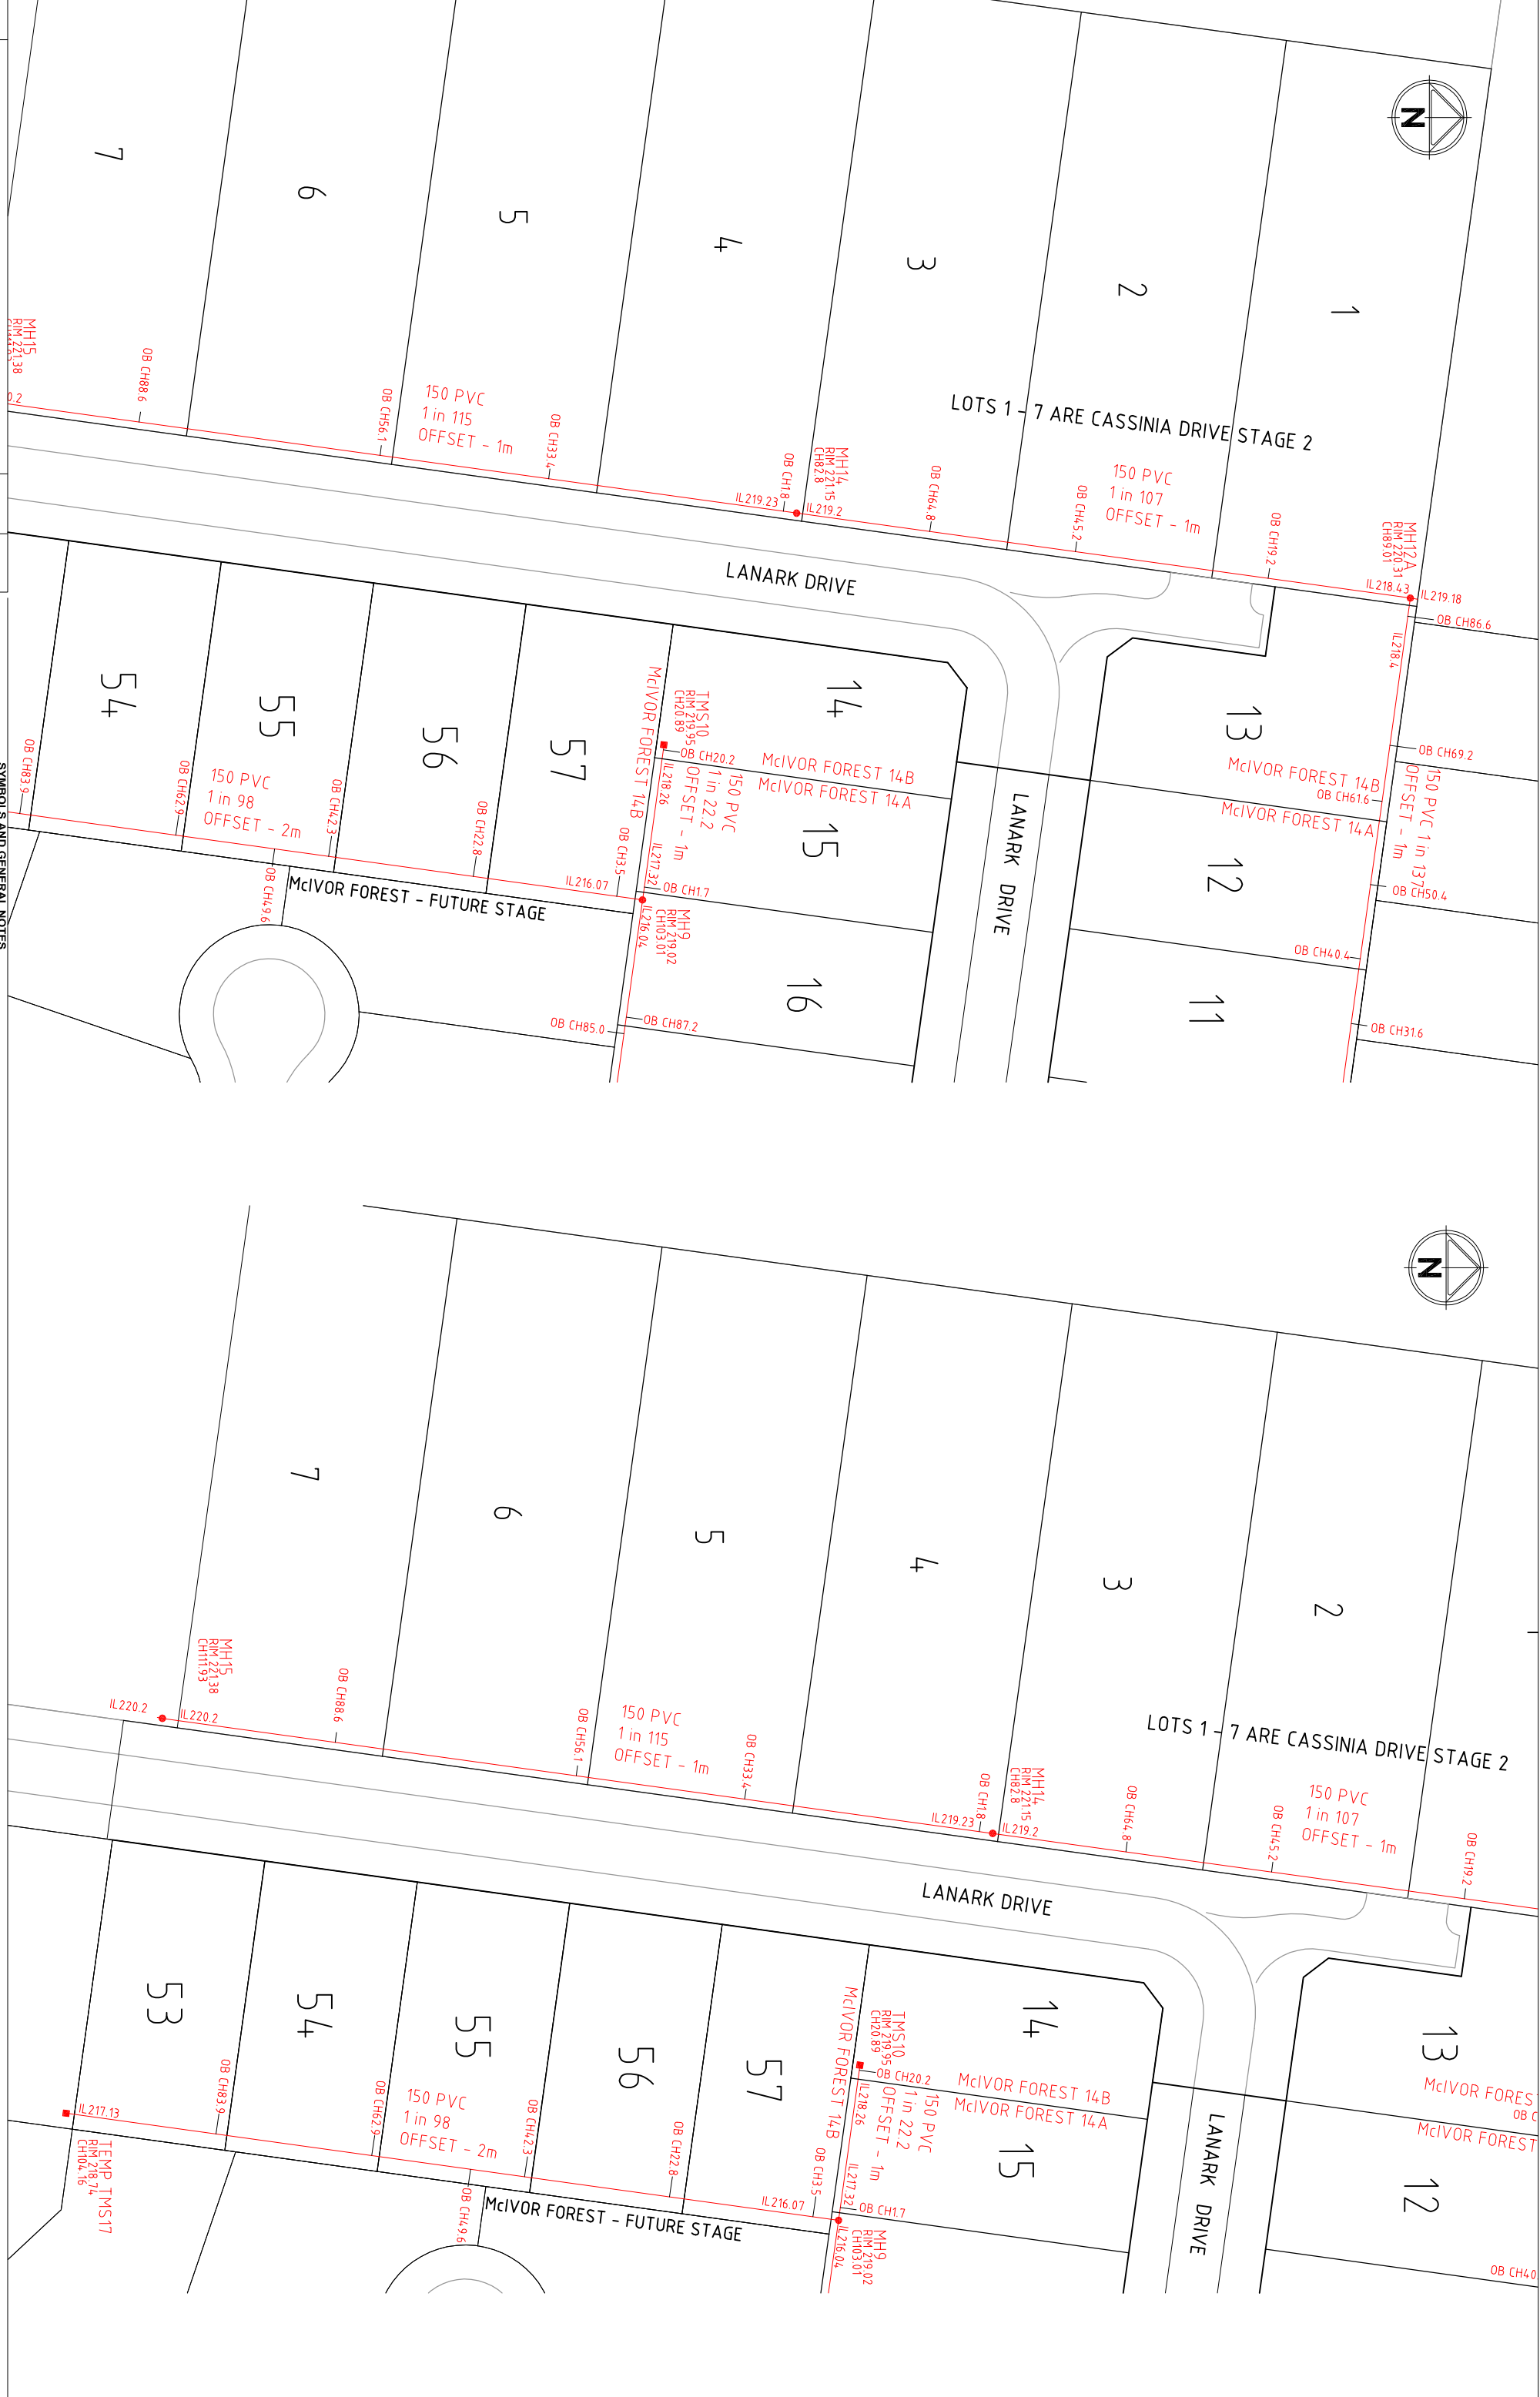

**COLIBAN WATER**  
**McIVOR FOREST ESTATE - STAGE 14B**  
**SEWERAGE RETICULATION EXTN No. SME 15800**  
**AS CONSTRUCTED SEWER PLAN**  
 CITY OF GREATER BENDIGO DS/1001/2003

**spire**  
 Innovation in Infrastructure

**DRG No** 300447 SAC  
**Rev** A  
**Ref** 300447