




GENERAL NOTES

- 1. THIS PLAN SHOWS DETAILS OF FILLING CARRIED OUT AS PART OF WORKS ON McIVOR FOREST ESTATE
- 2. FILL DEPTHS ARE APPROXIMATE & INDICATIVE ONLY AND THIS PLAN SHOULD BE CONSIDERED IN CONJUNCTION WITH SITE INVESTIGATIONS CARRIED OUT BY GEOTECHNICAL TESTING SERVICES
- 3. THIS PLAN DOES NOT SHOW ANY OTHER FILL WHICH MAY HAVE BEEN PLACED PRIOR TO RESIDENTIAL SUBDIVISION OF THE LAND. ANY GRADING OR SPREADING TO CORRECT MINOR SURFACE IRREGULARITIES LESS THAN 300mm IS NOT SHOWN. DEPTHS SHOWN ARE NOT RECOMMENDED FOUNDATION DEPTHS.

LEGEND - FILL DEPTHS

	FILL 300mm - 600mm
	FILL 600mm - 800mm

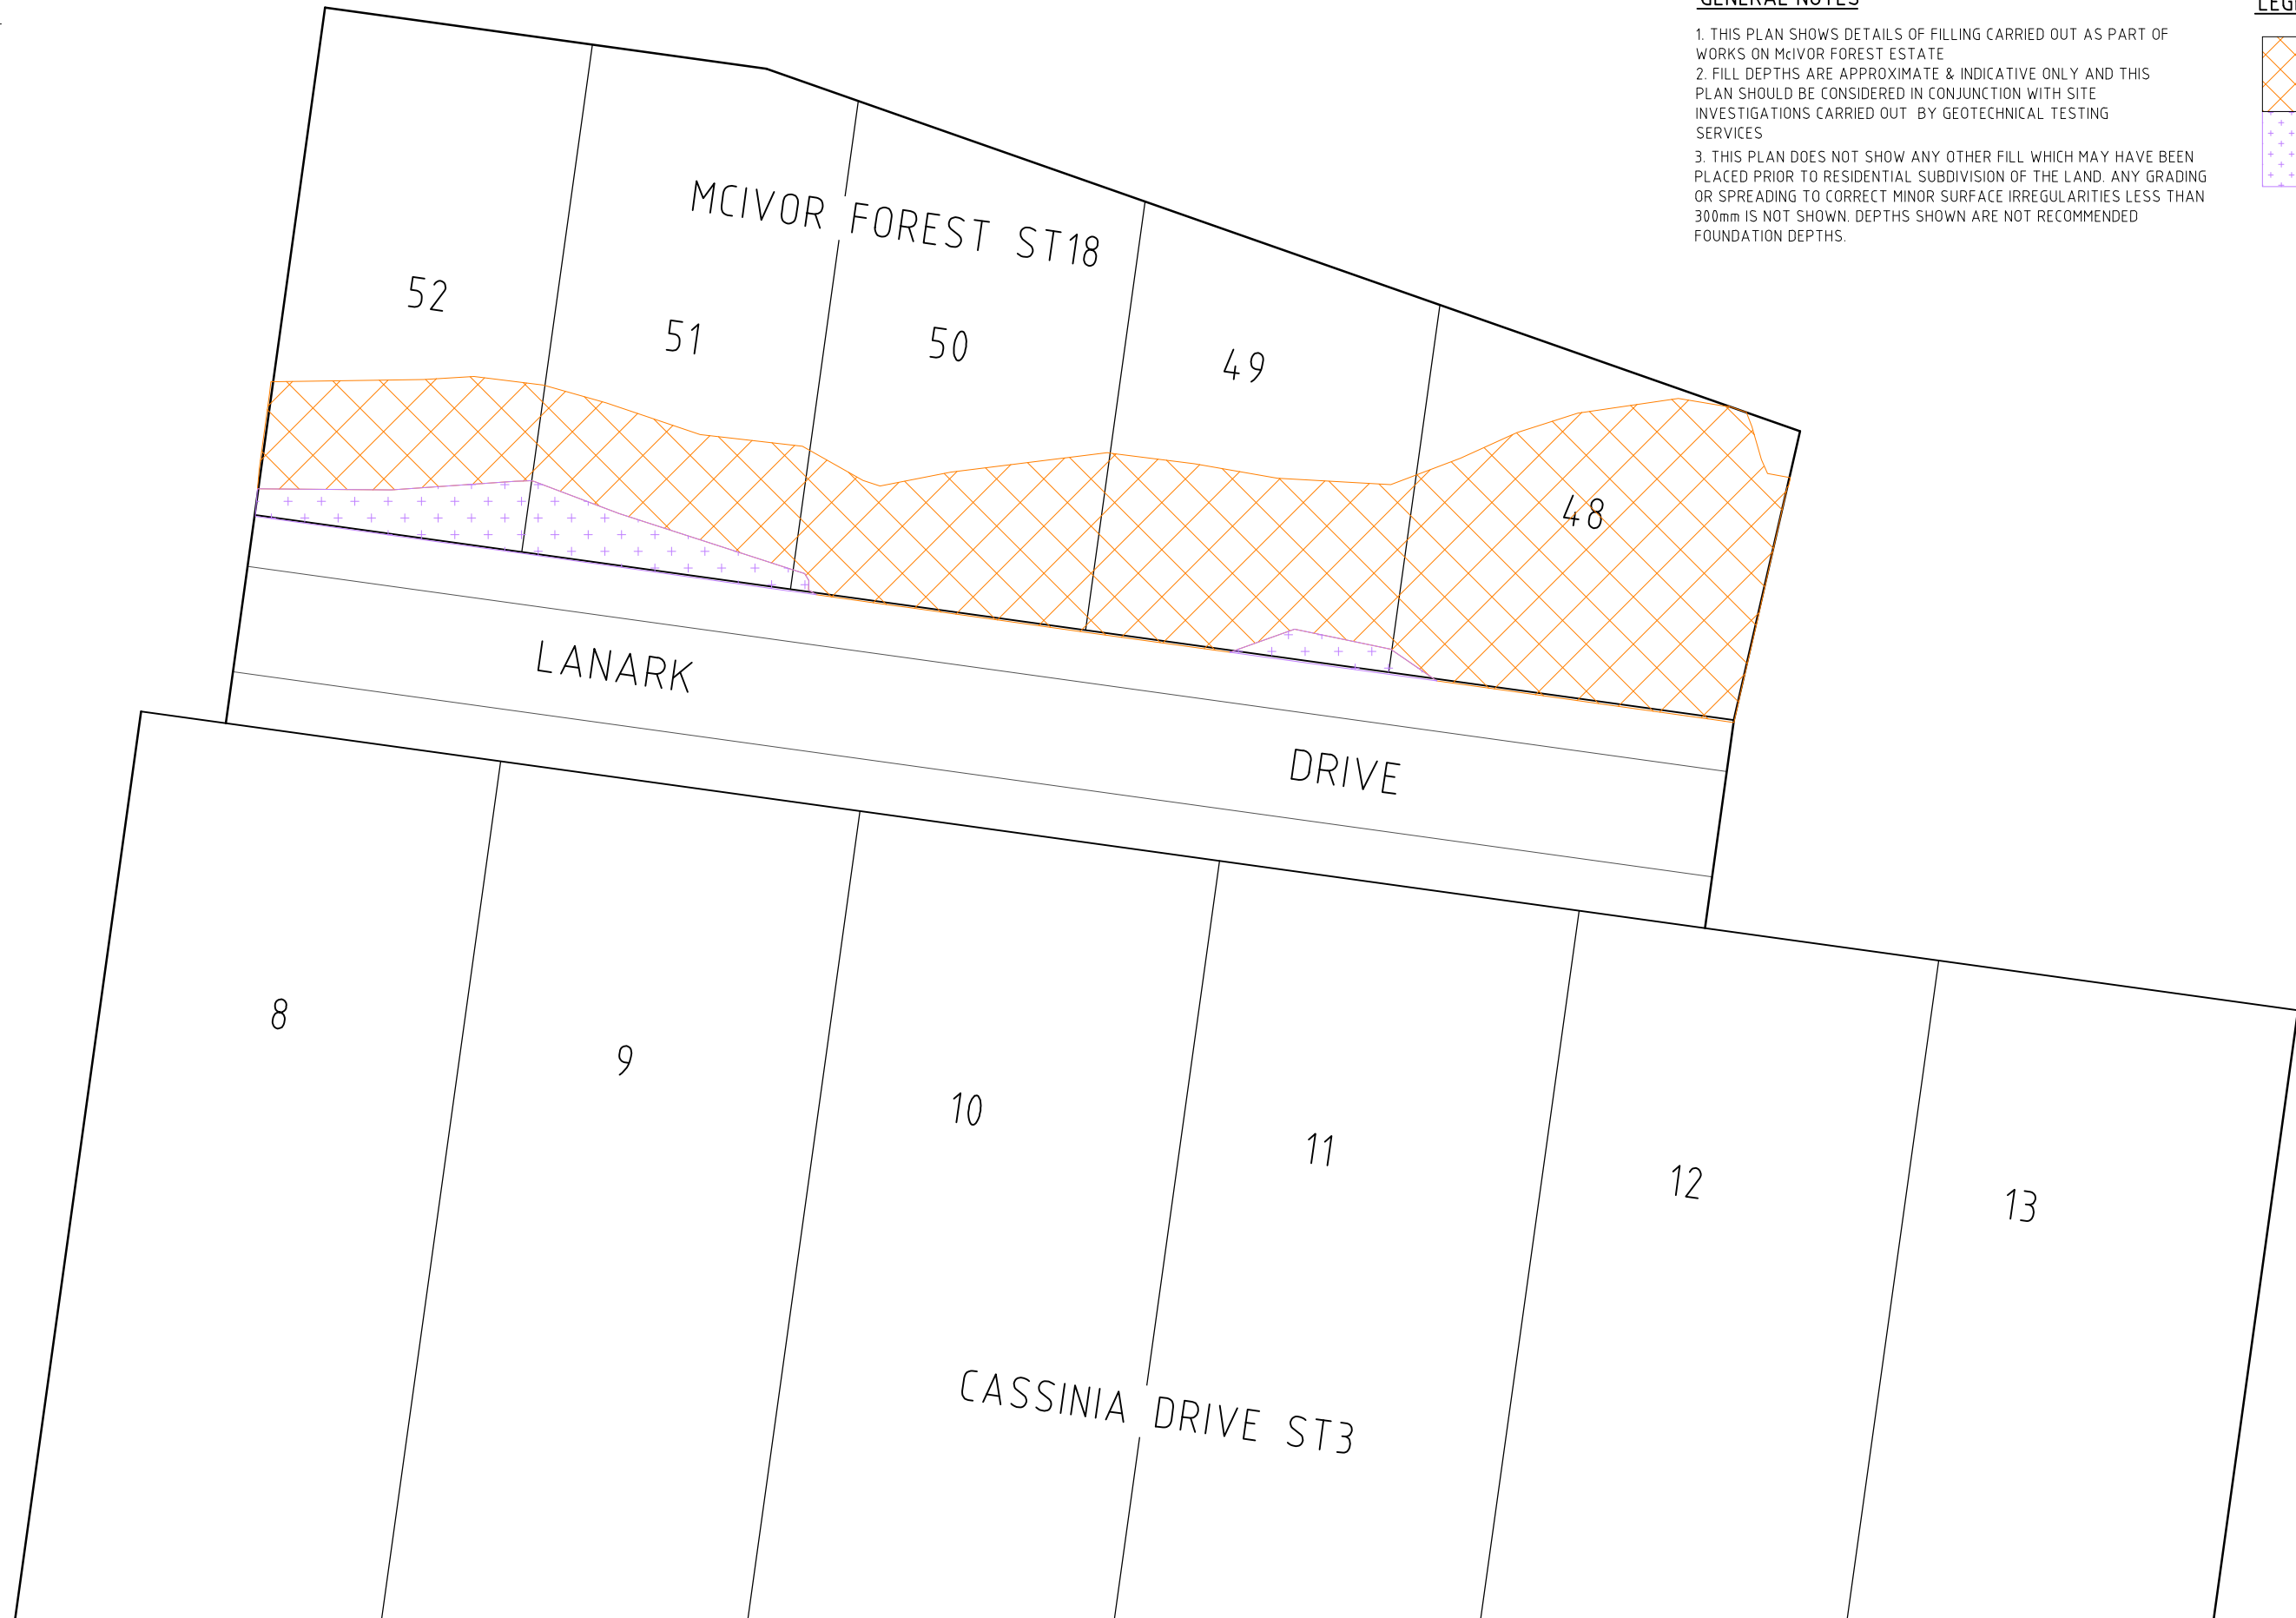

A	AS CONSTRUCTED FILL PLAN	B.I.	APR 17
Rev	Amendments	App'd	Date

file name 301941FP1.dwg layout name FP1
file location G:\30\301941\ACAD
plotted by Brendan Ibbes plot date 13/4/2017 10:36 AM
© Spiire Australia Pty Ltd
Standard Drawing RDA1 - Version 20120911

Scale 1:250, A1
Horizontal 0 2.5 5 7.5 10 12.5
Vertical 0 2.5 5 7.5 10 12.5

Designed K.ELDRIDGE APR 2017
Checked B.IBBS APR 2017
Authorised B.IBBS APR 2017

Map Reference VICROADS 608 K10 Ed7
Sheet Number 01
Drg Status FOR APPROVAL

spiire ABN 55 050 029 635
16 Bridge Street Bendigo Victoria 3550 Australia T 61 3 5448 2500
spiire.com.au

spiire
Innovation in Infrastructure

**McIVOR FOREST STAGE 18
LANARK DRIVE, JUNORTOWN
AS CONSTRUCTED FILL PLAN**

McIVOR FOREST ESTATE PTY LTD
CITY OF GREATER BENDIGO DS/1001/2003

Rev A
Drg No 301941FP01